



**29970 TECHNOLOGY DR.
TEMECULA, CA**

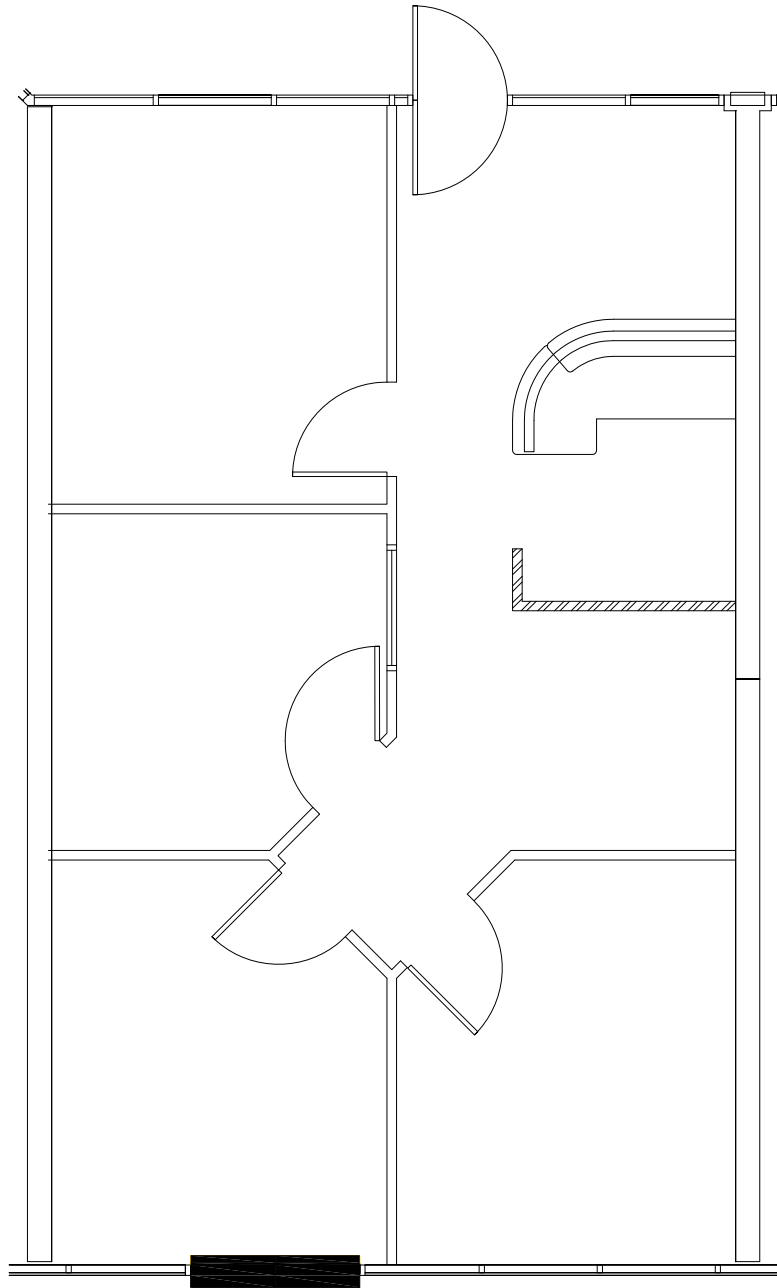

SUITE 116

AREA: 1,055

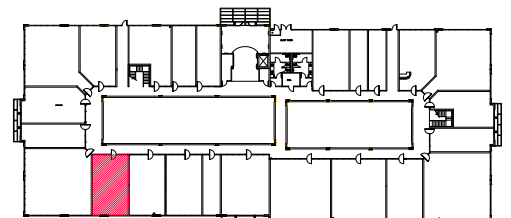

FLOOR: 01